


NO.	DATE	DESCRIPTION
6/20/11	AS-BUILT PLAN	

COPYRIGHT © PFDA, INCORPORATED
 ALL DRAWINGS AND WRITTEN INFORMATION
 PERTAINING HEREON SHALL NOT BE REPRODUCED
 OR TRANSMITTED IN ANY FORM OR BY ANY MEANS
 WITHOUT WRITTEN CONSENT.
 DRAWN BY: CHECKED BY:

SHEET

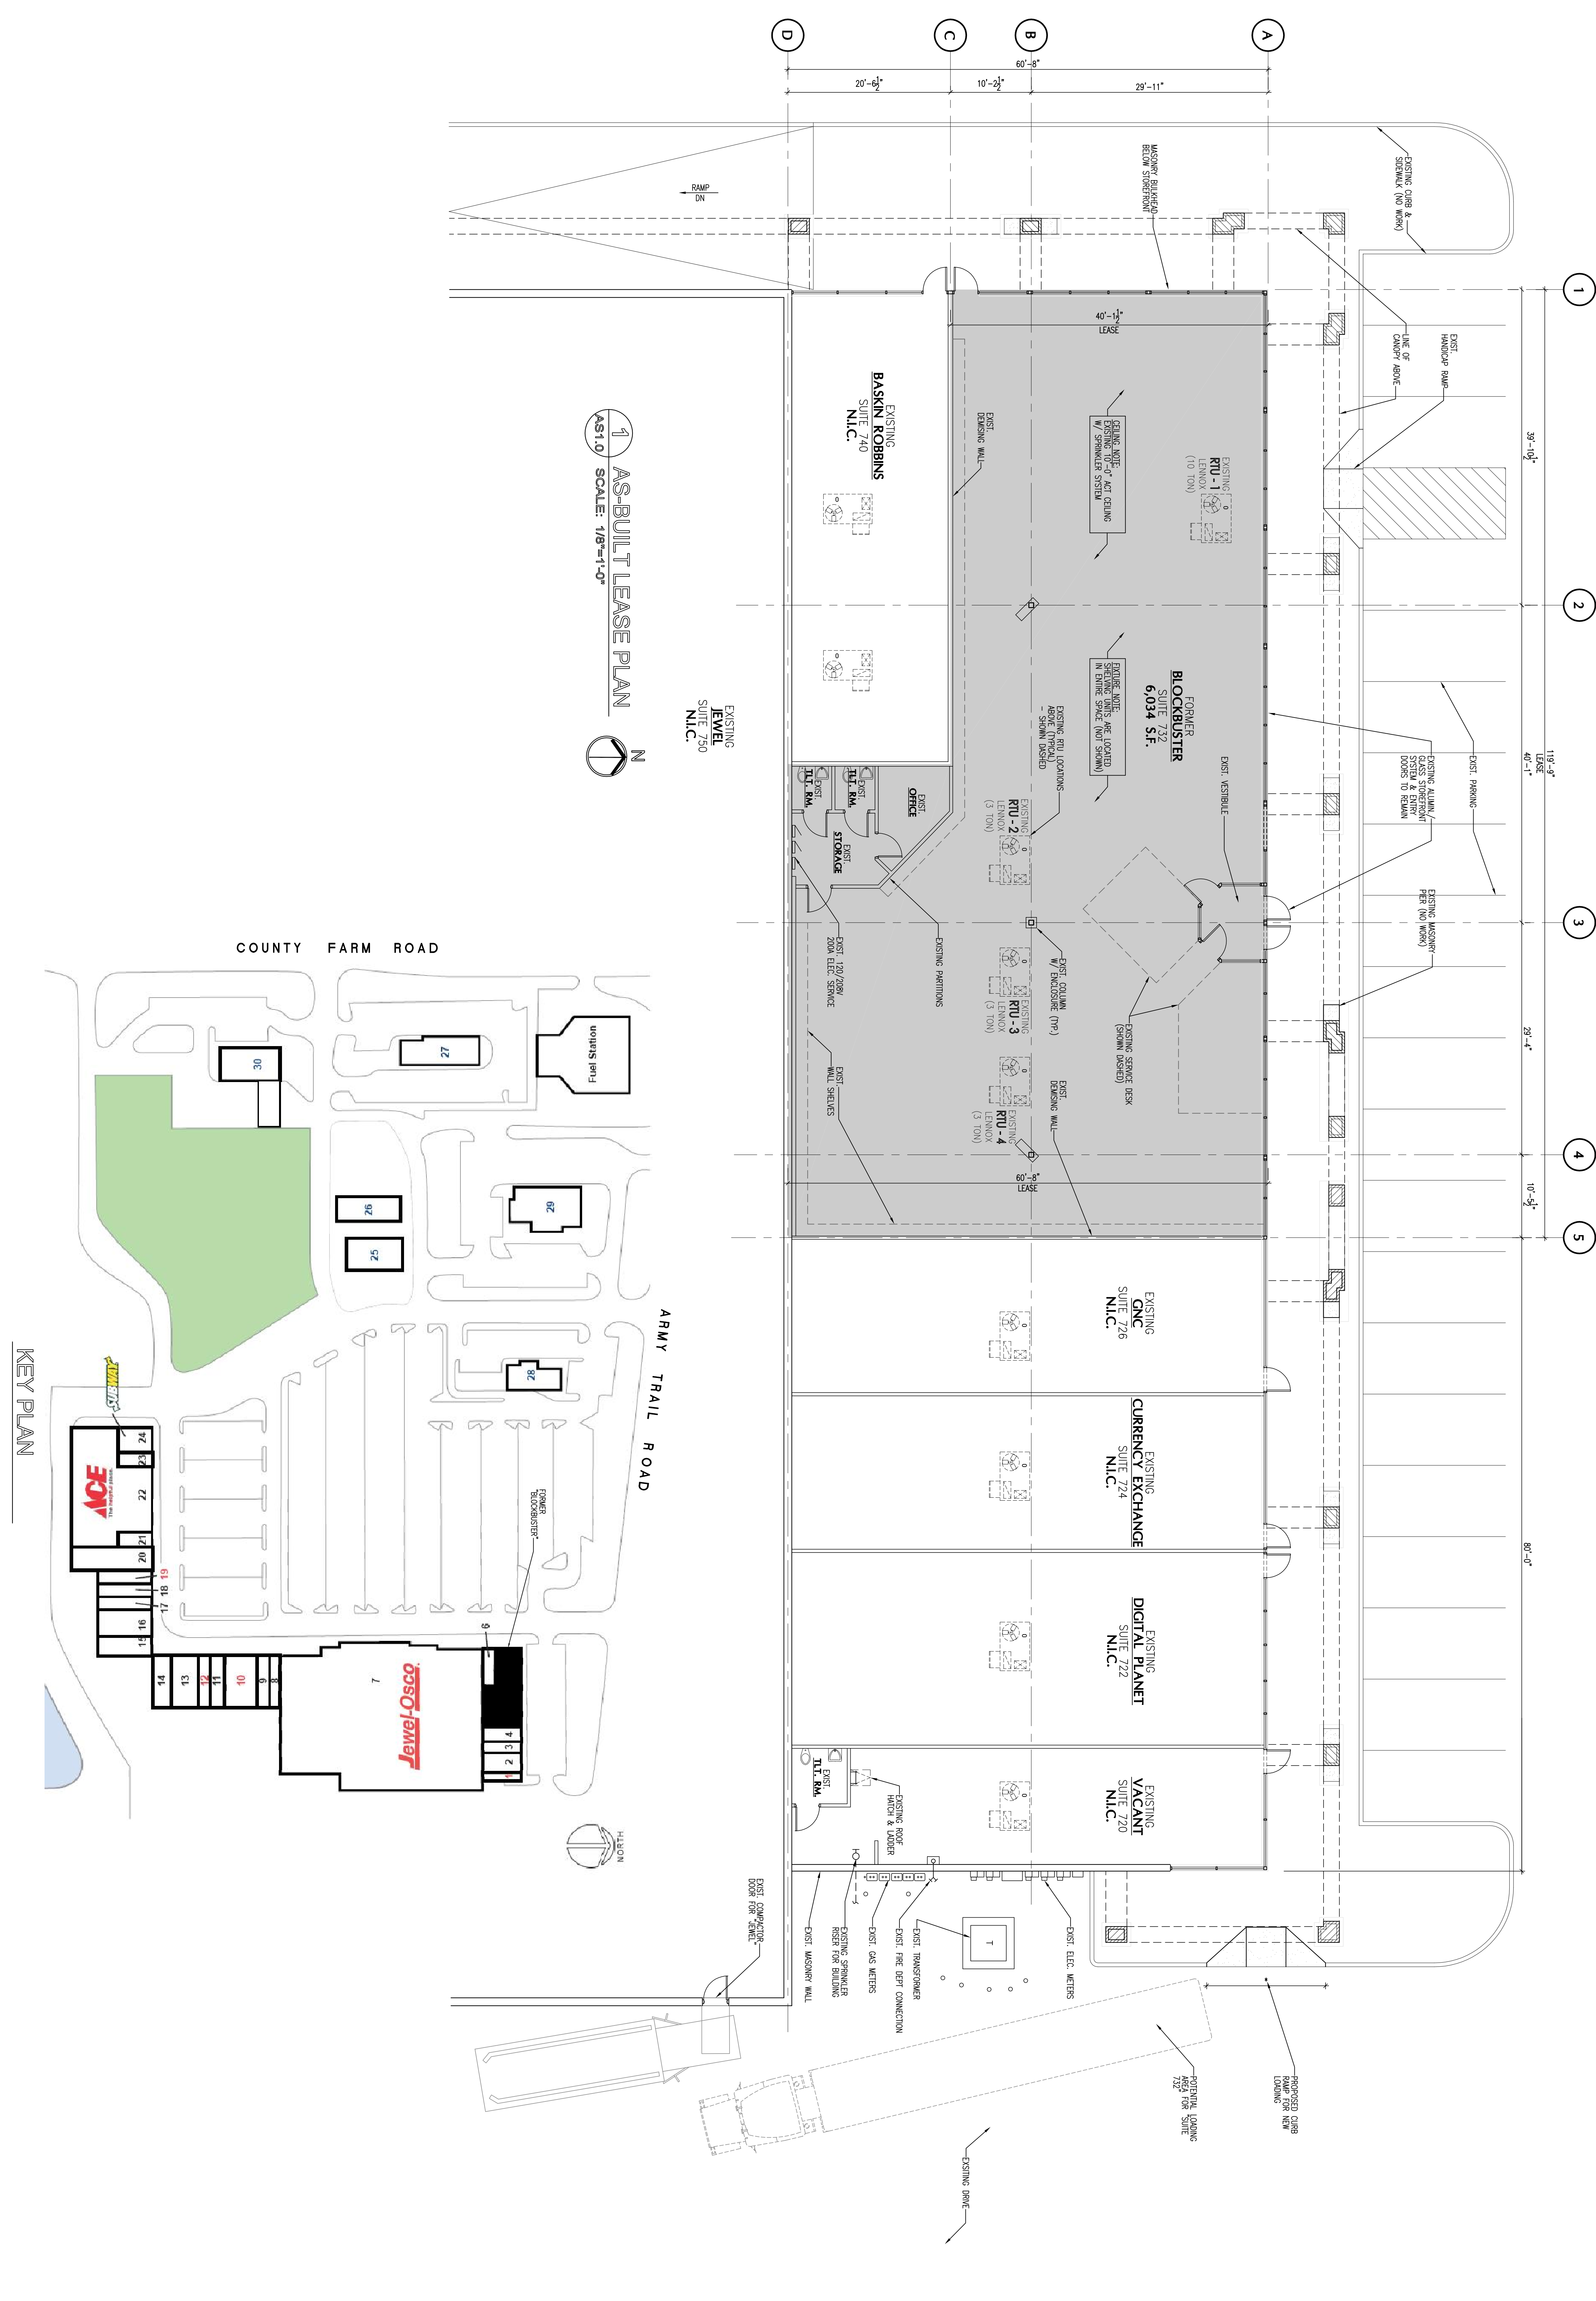

1 AS-BUILT LEASE PLAN
 AS10 SCALE: 1/8"=1'-0"

