


NO.	DATE	DESCRIPTION
10/20/15	AS-BUILT PLAN	

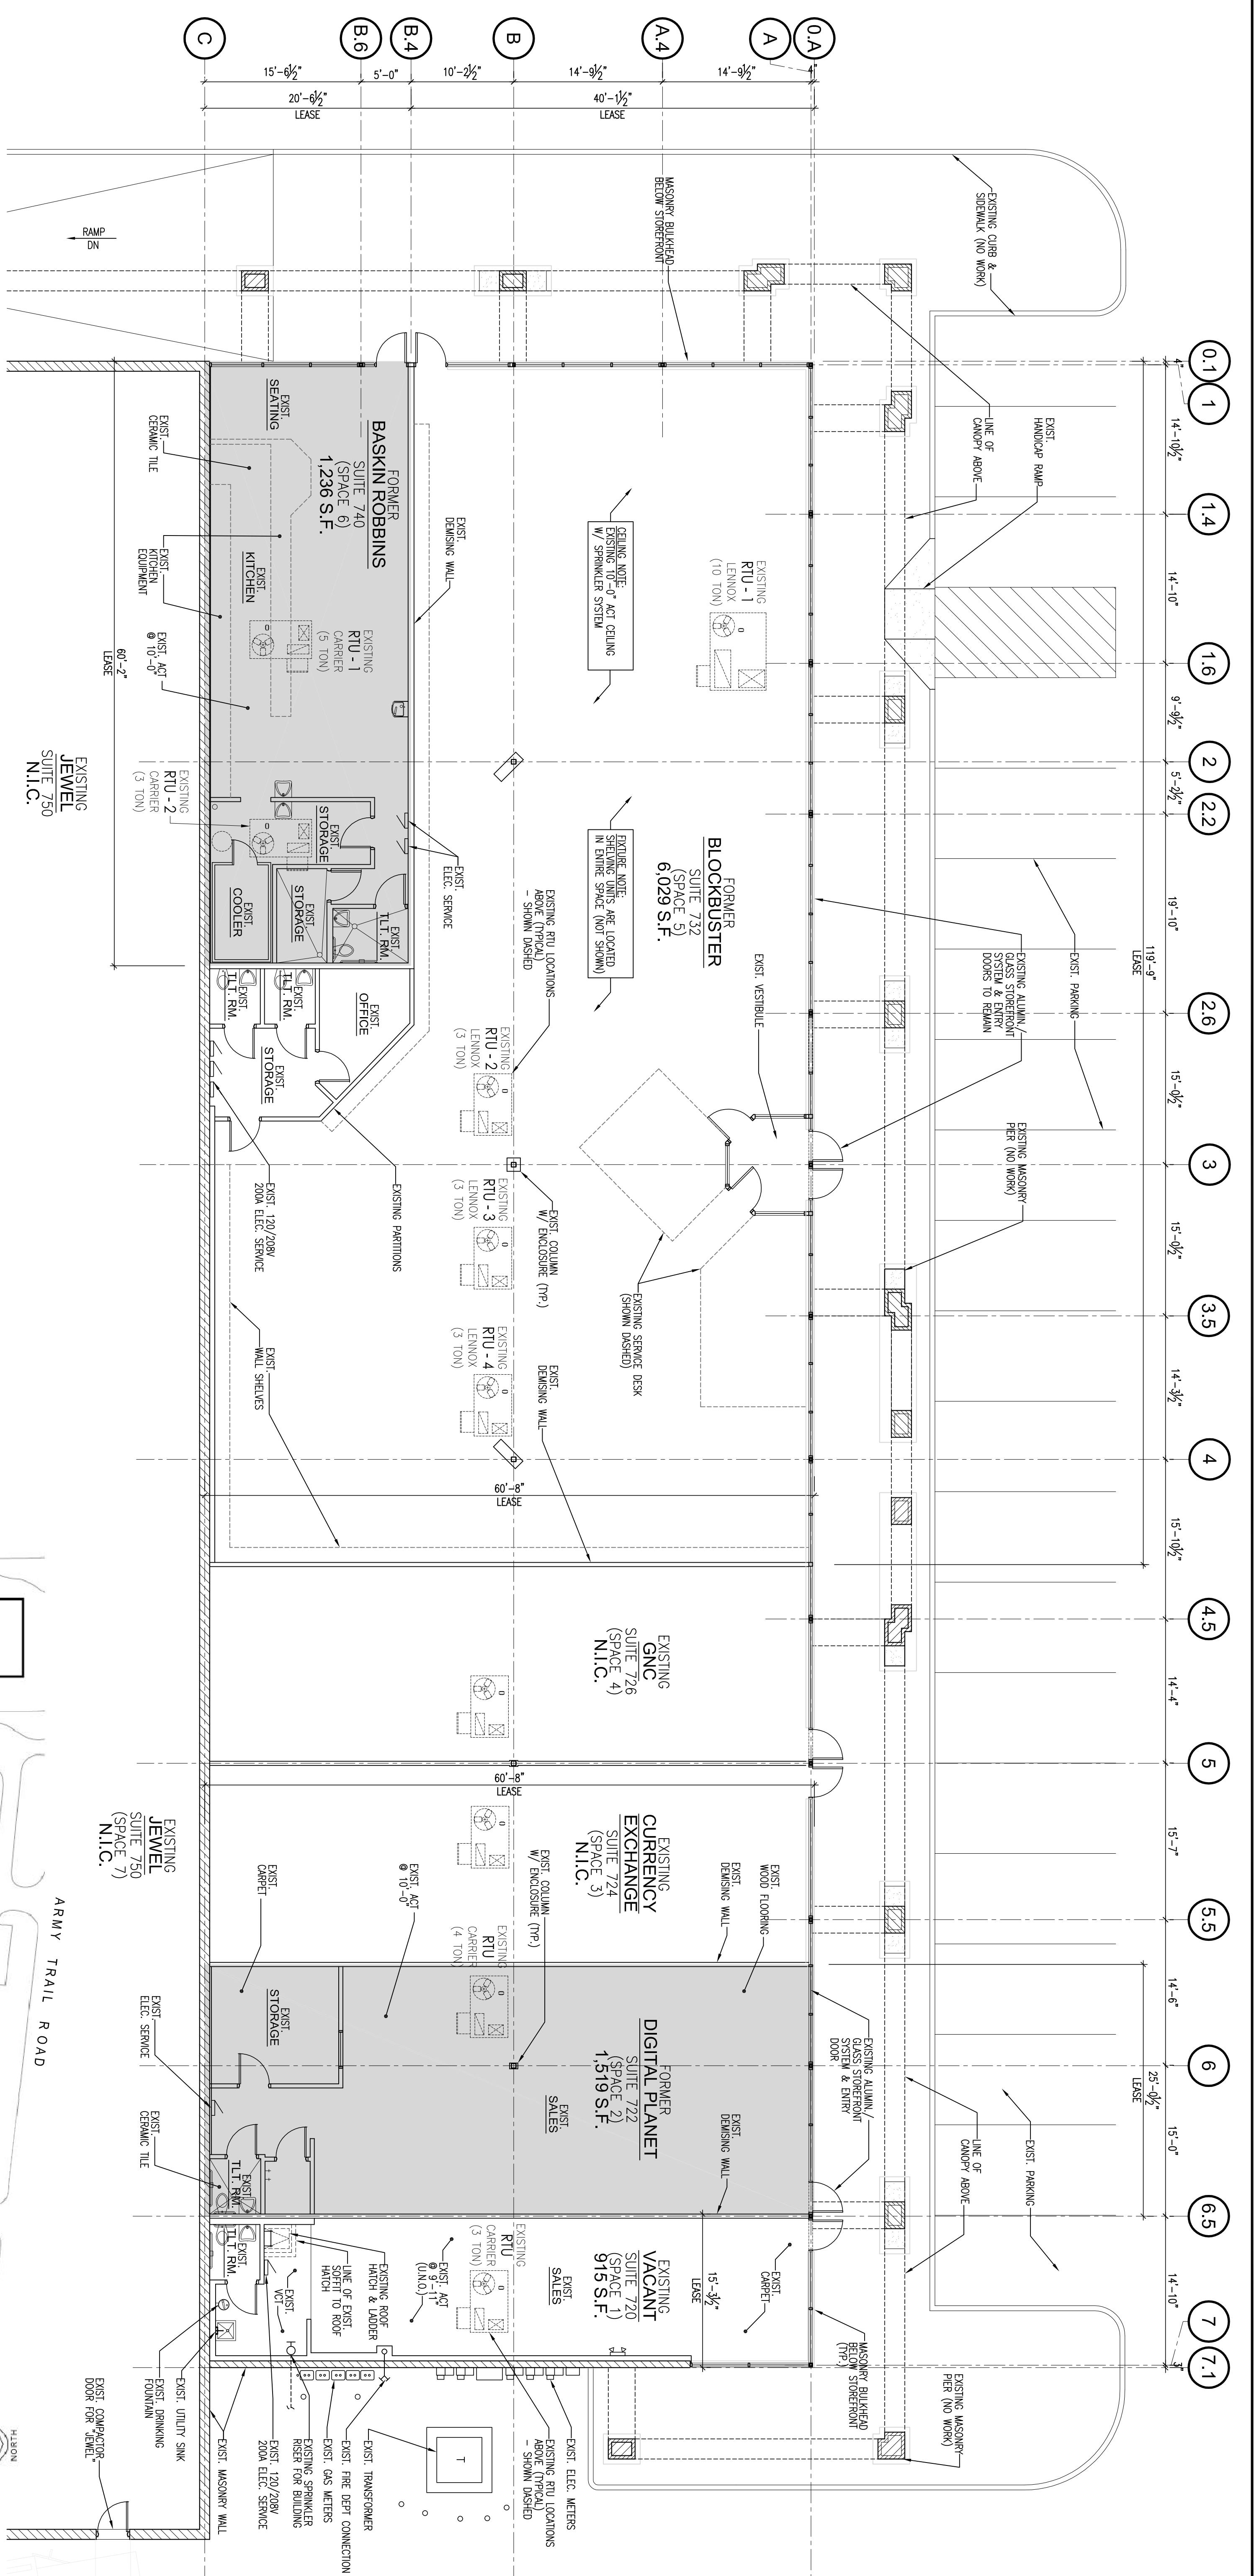

**1 AS-BUILT LEASE PLAN**  
AS1.0 SCALE: 1/8"=1'-0"

**2 KEY PLAN**  
AS1.0 SCALE: N.T.S.

