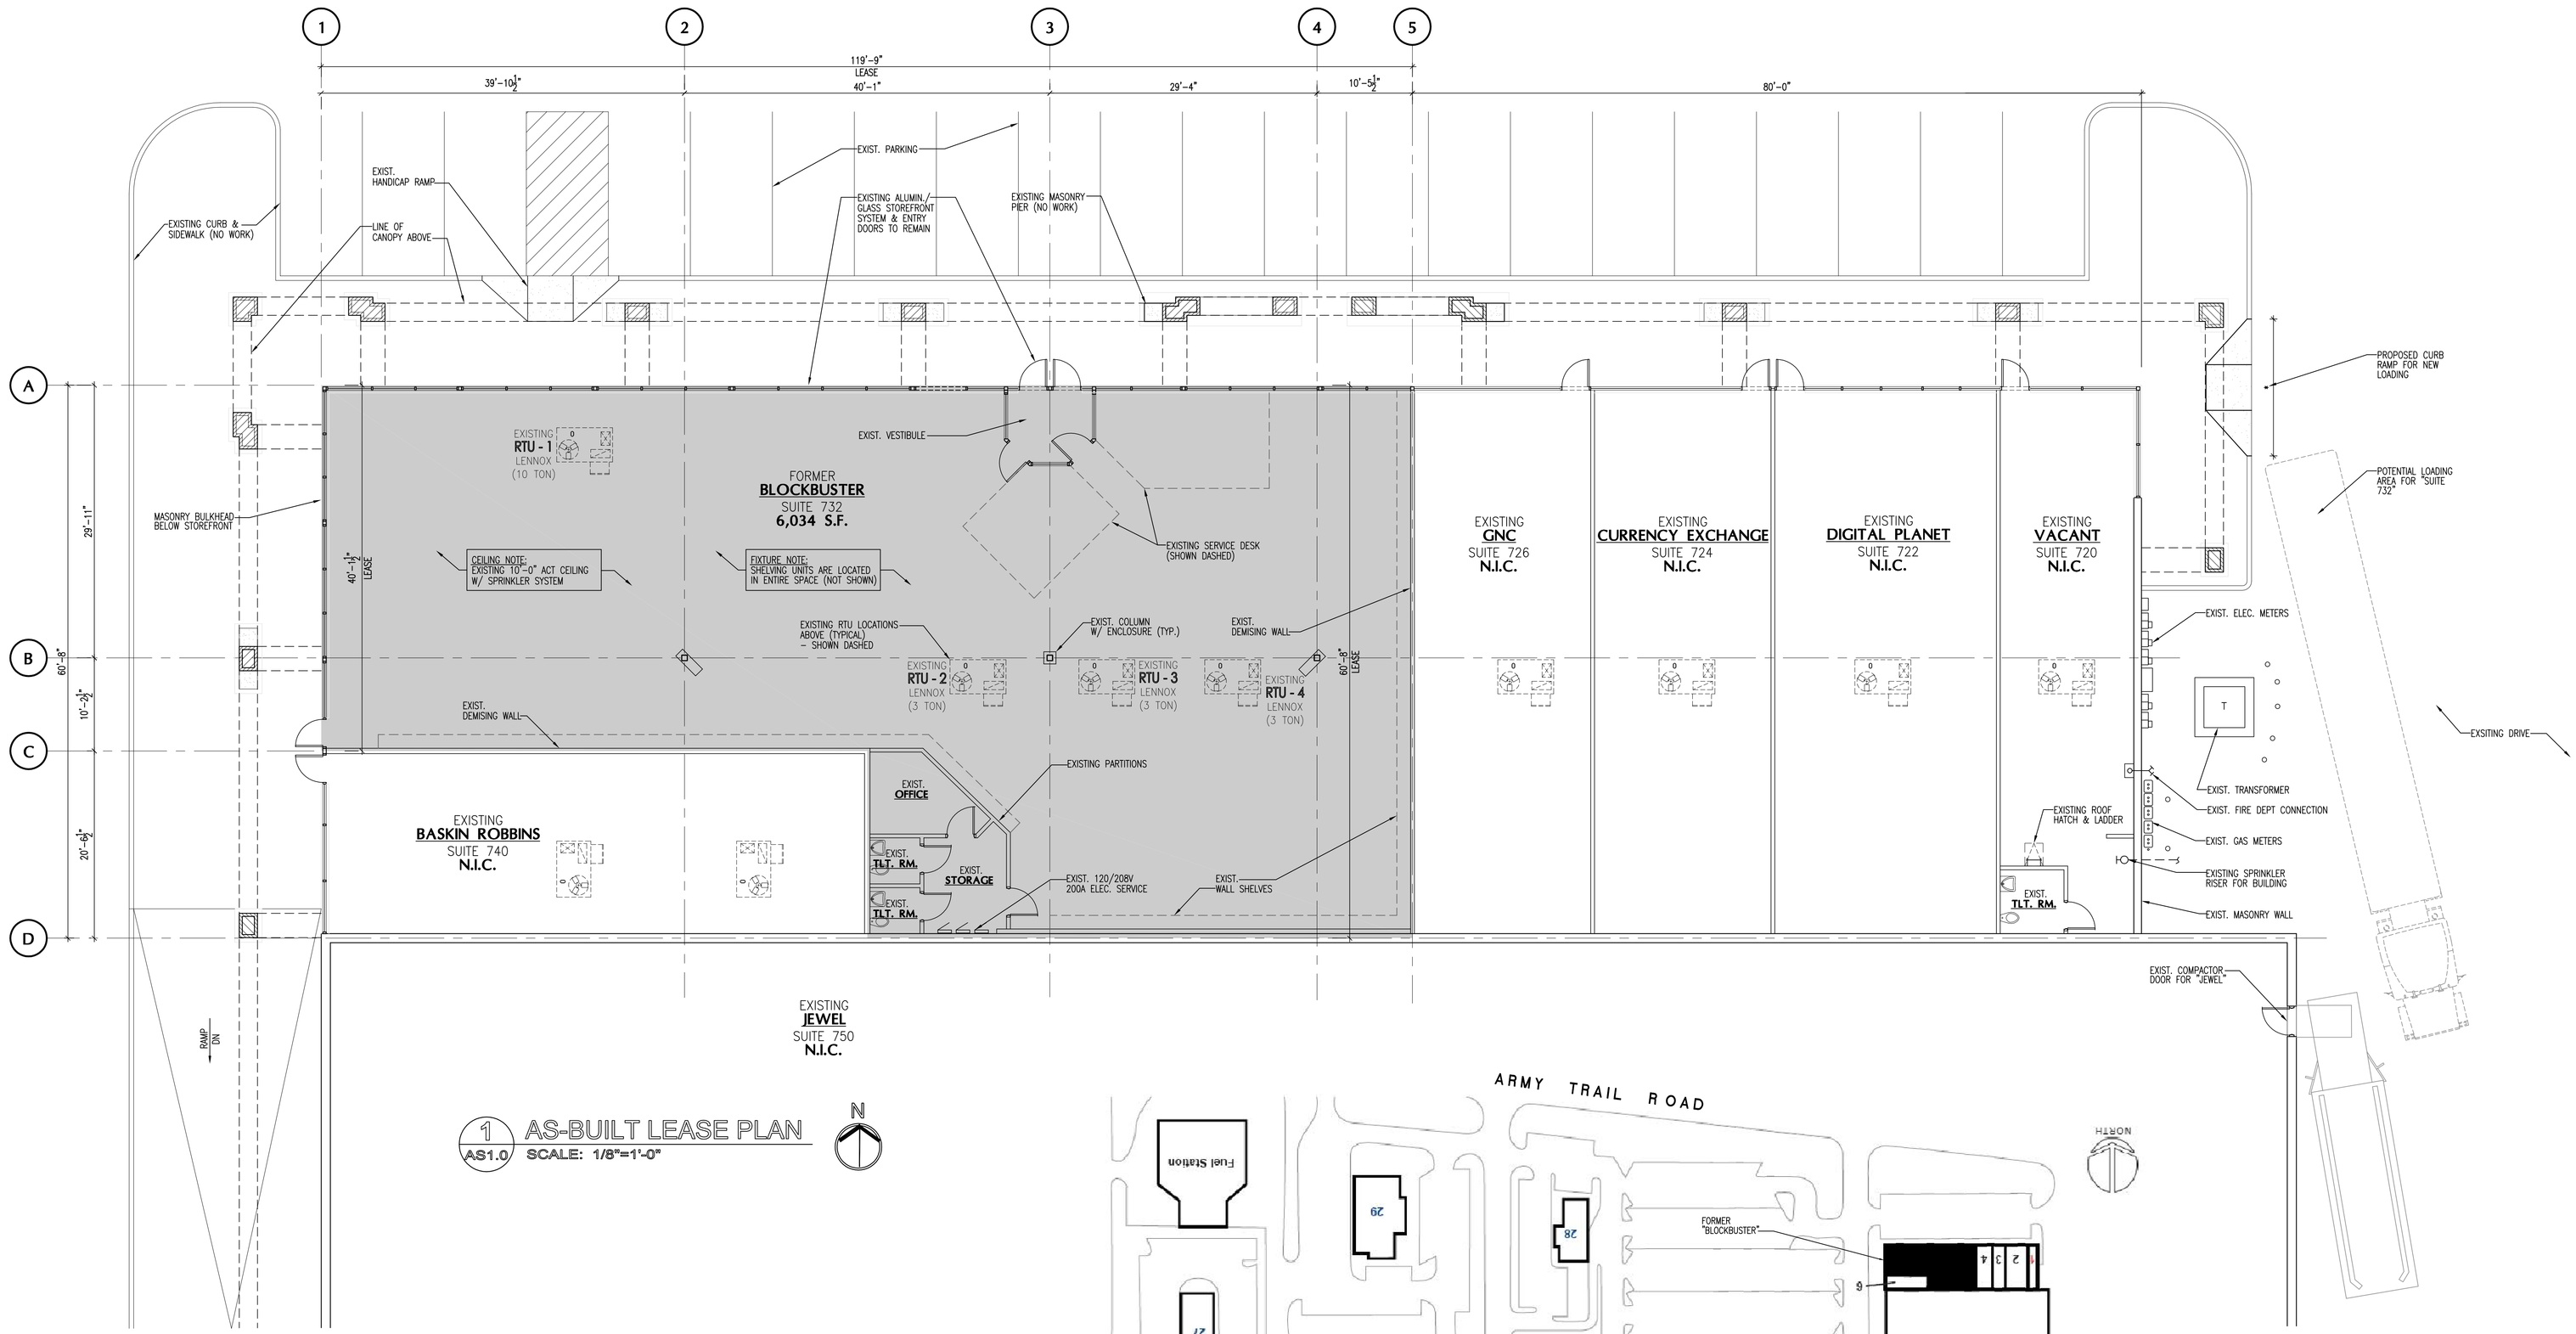

1 AS1.0 AS-BUILT LEASE PLAN
SCALE: 1/8"=1'-0"

N

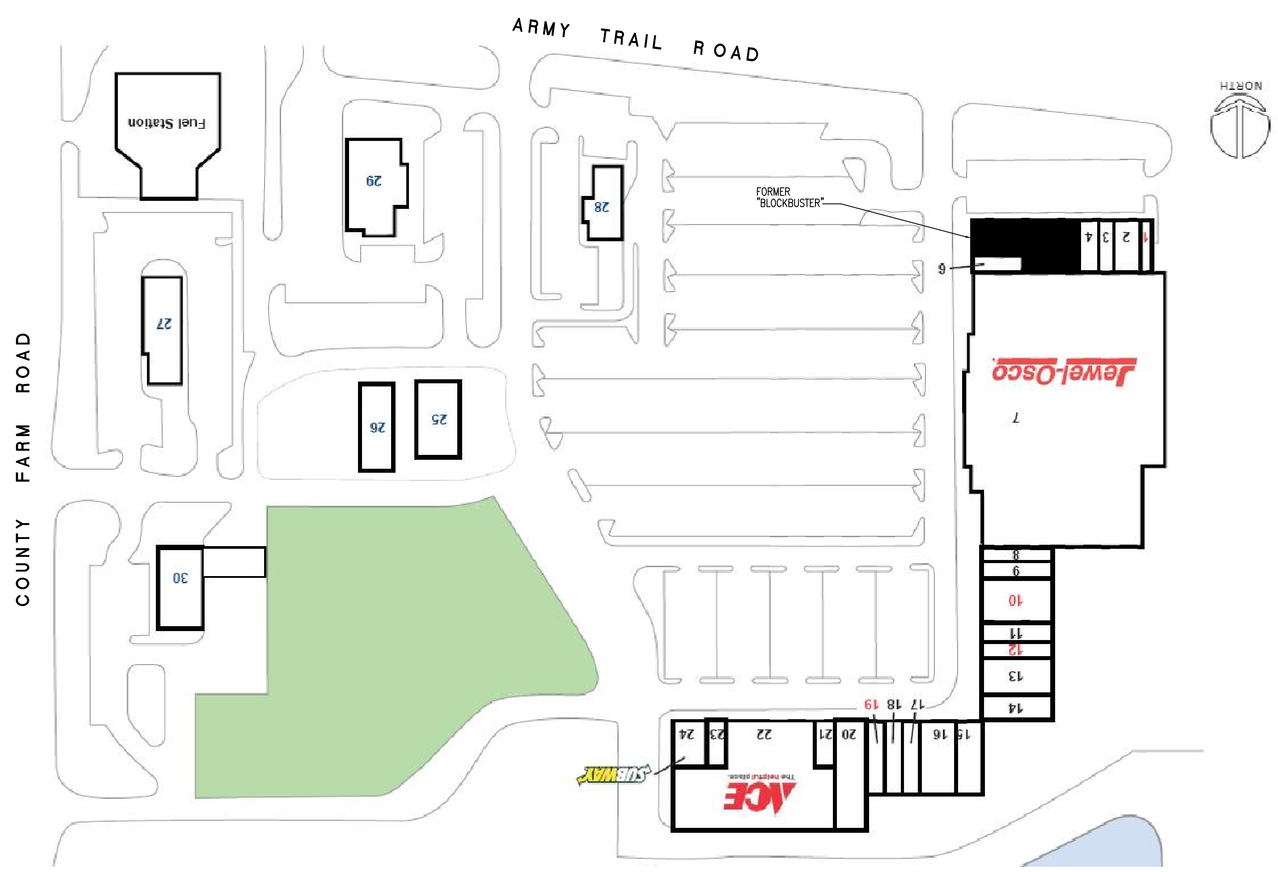

KEY PLAN

PFDA ARCHITECTS, INC.
2803 BUTTERFIELD RD.
SUITE 340
OAK BROOK, IL 60523
TEL: (312) 795-1245
FAX: (312) 795-6123

OWNER:

INLAND AMERICAN HOLDCO MANAGEMENT

2901 BUTTERFIELD ROAD
OAK BROOK, IL 60523

PROJECT:

AS-BUILT
LEASE PLAN

HERITAGE PLAZA
SHOPPING CENTER
732 ARMY TRAIL ROAD
CAROL STREAM, IL 60188

SHEET TITLE:

AS-BUILT
LEASE PLAN

NO.	DATE	DESCRIPTION
	6/3/11	AS-BUILT PLAN

COPYRIGHT - PFDA, INCORPORATED
ALL DRAWN AND WRITTEN INFORMATION APPEARING HEREIN SHALL NOT BE DUPLICATED, DISCLOSED OR OTHERWISE WITHOUT WRITTEN CONSENT.

DRAWN BY: | CHECKED BY:

SHEET

AS1.0

JOB NO. 11076