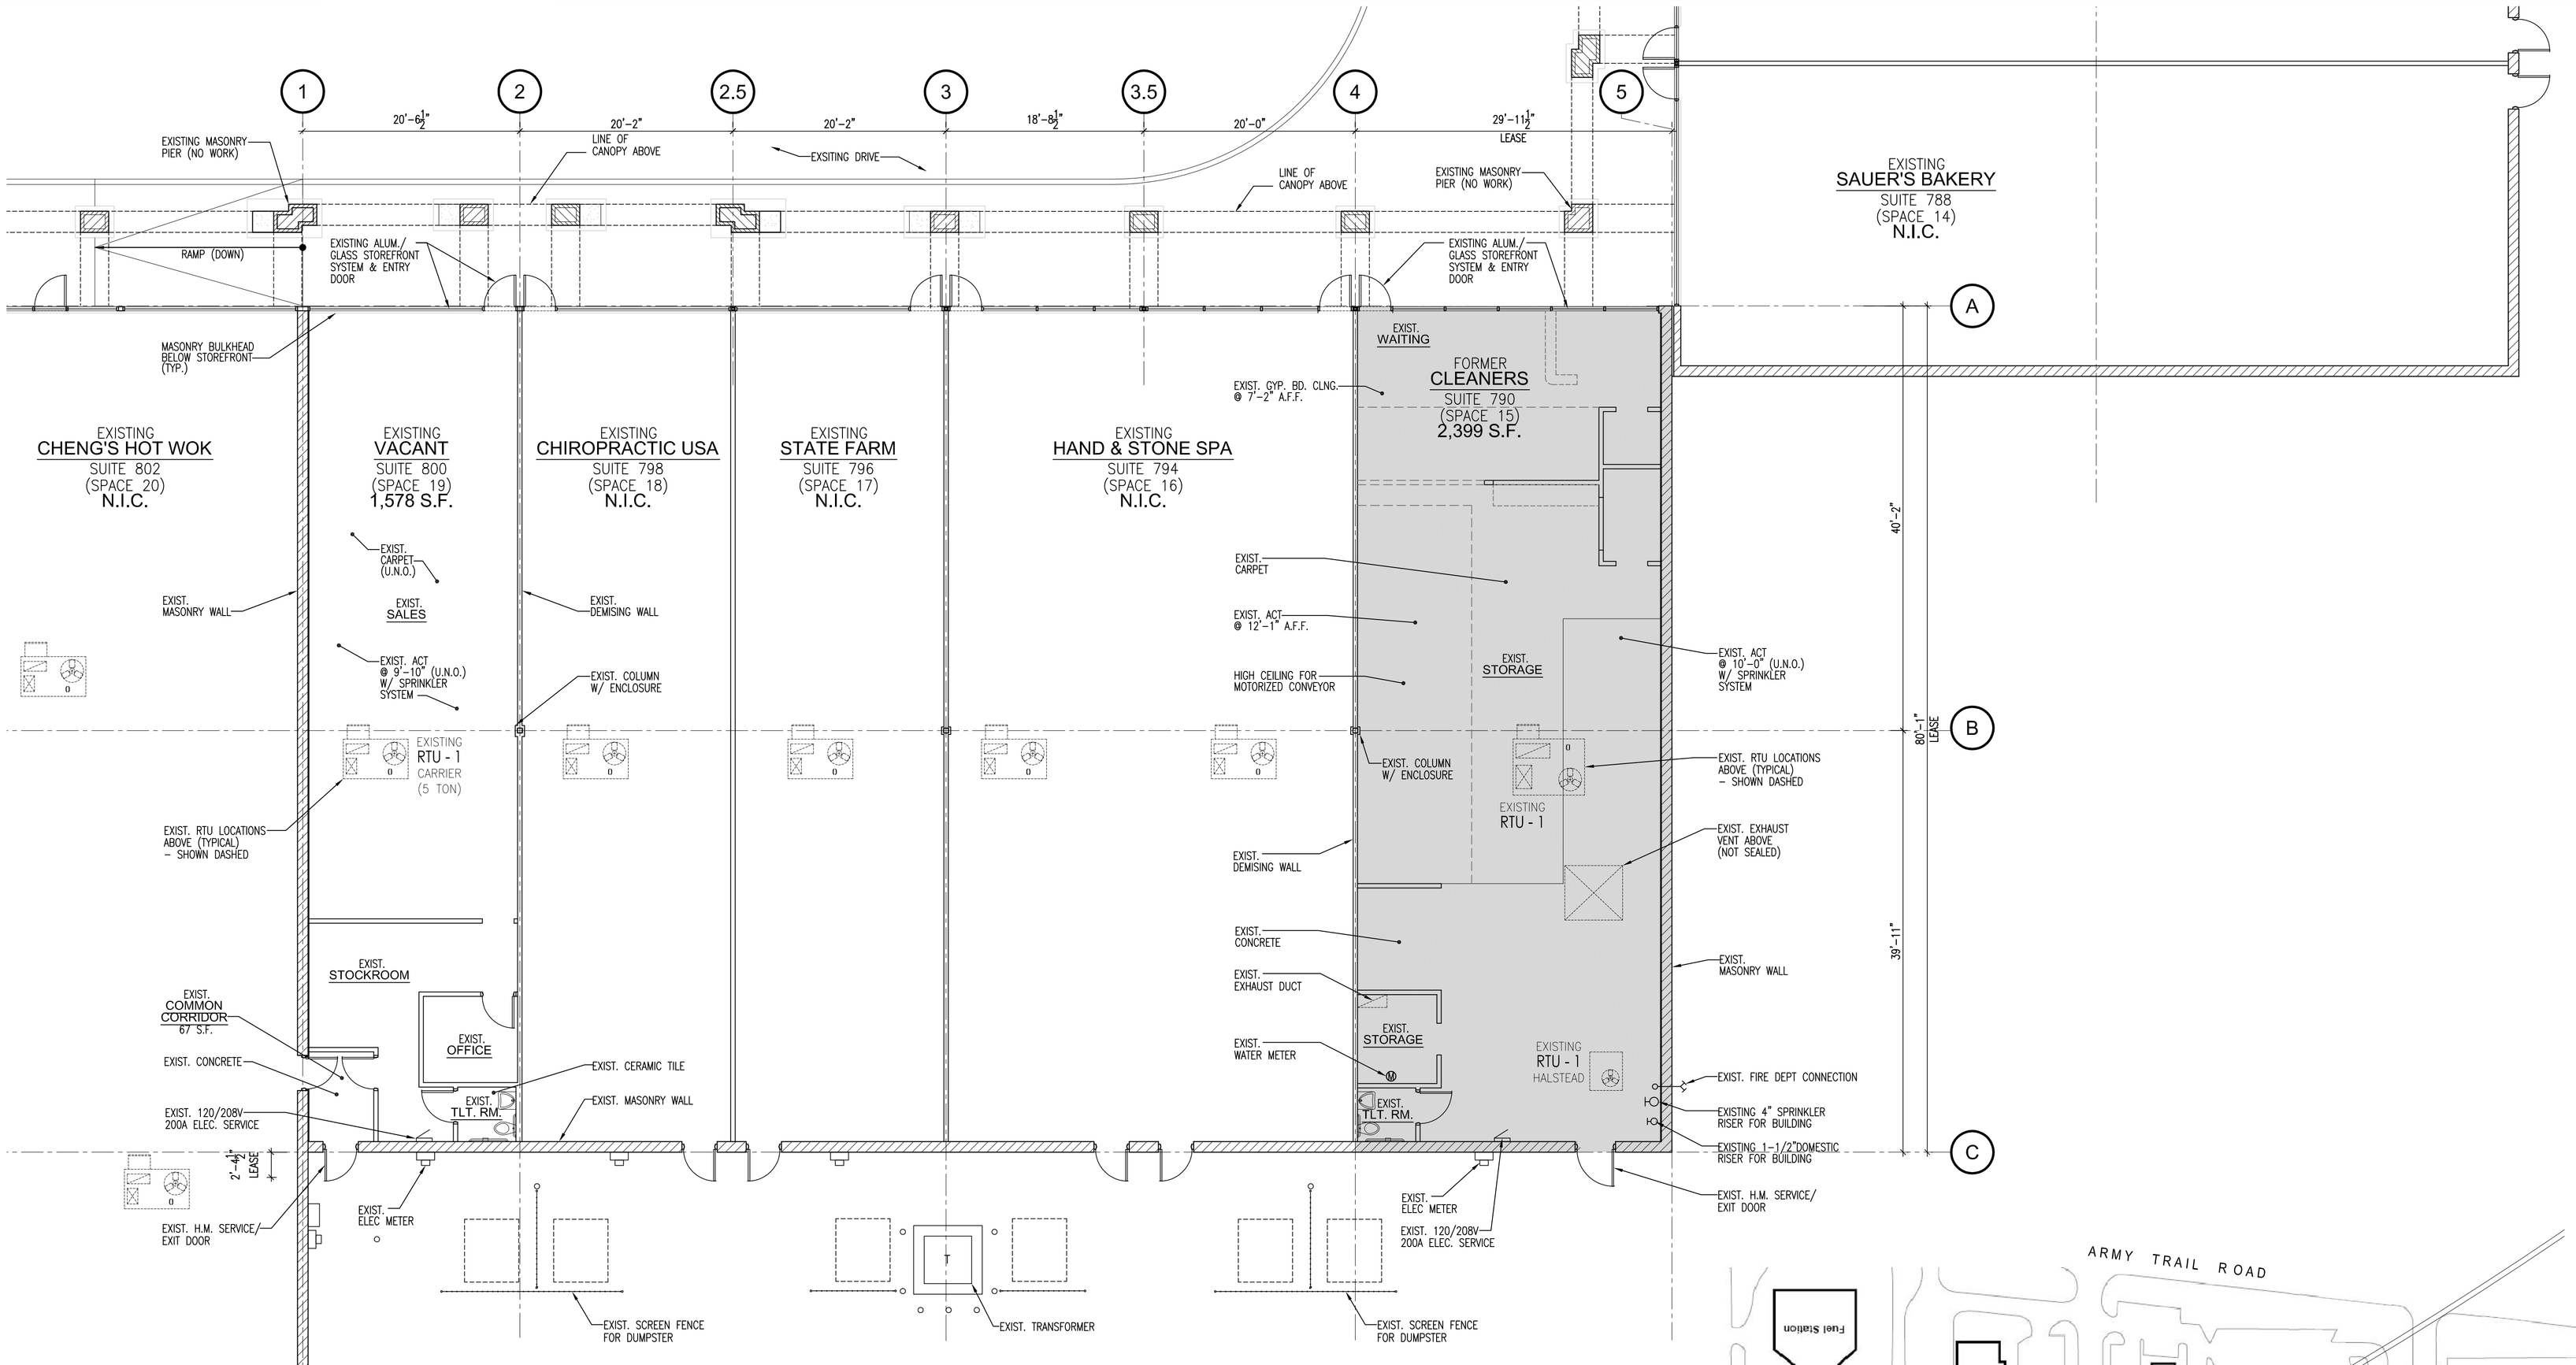

1 AS-BUILT LEASE PLAN
AS1.0 SCALE: 1/8"=1'-0"

N

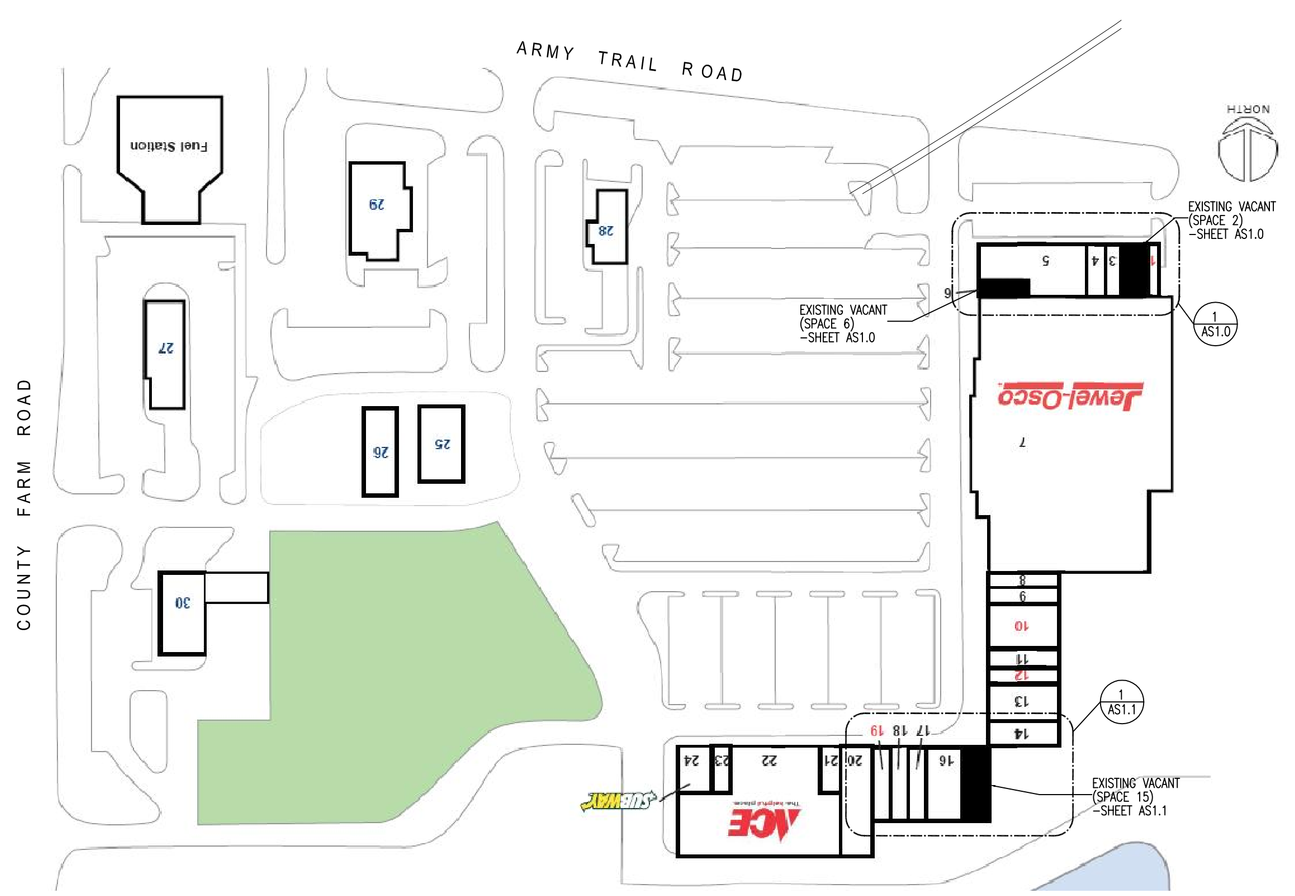

2 KEY PLAN
AS1.0 SCALE: N.T.S.

PFDA ARCHITECTS, INC.
2803 BUTTERFIELD RD.
SUITE 340
OAK BROOK, IL 60523
TEL: (312) 795-1245
FAX: (312) 795-6123

OWNER:

InvenTrust Properties

InvenTrust Property Management, LLC
2809 BUTTERFIELD ROAD, Suite 200
OAK BROOK, IL 60523

PROJECT:

AS-BUILT LEASE PLAN

HERITAGE PLAZA SHOPPING CENTER
732 ARMY TRAIL ROAD
CAROL STREAM, 60188

SHEET TITLE:

AS-BUILT LEASE PLAN (SPACE 15)

NO.	DATE	DESCRIPTION
	10.20.15	AS-BUILT PLAN

COPYRIGHT - PFDA, INCORPORATED
ALL DRAWN AND WRITTEN INFORMATION APPEARING HEREIN SHALL NOT BE DUPLICATED, DISCLOSED OR OTHERWISE WITHOUT WRITTEN CONSENT.

DRAWN BY:	CHECKED BY:

SHEET

AS1.1

JOB NO. 15065